H1- IOT2L

LIGO-D1300357-v1

'as-built' as of Science Run O1
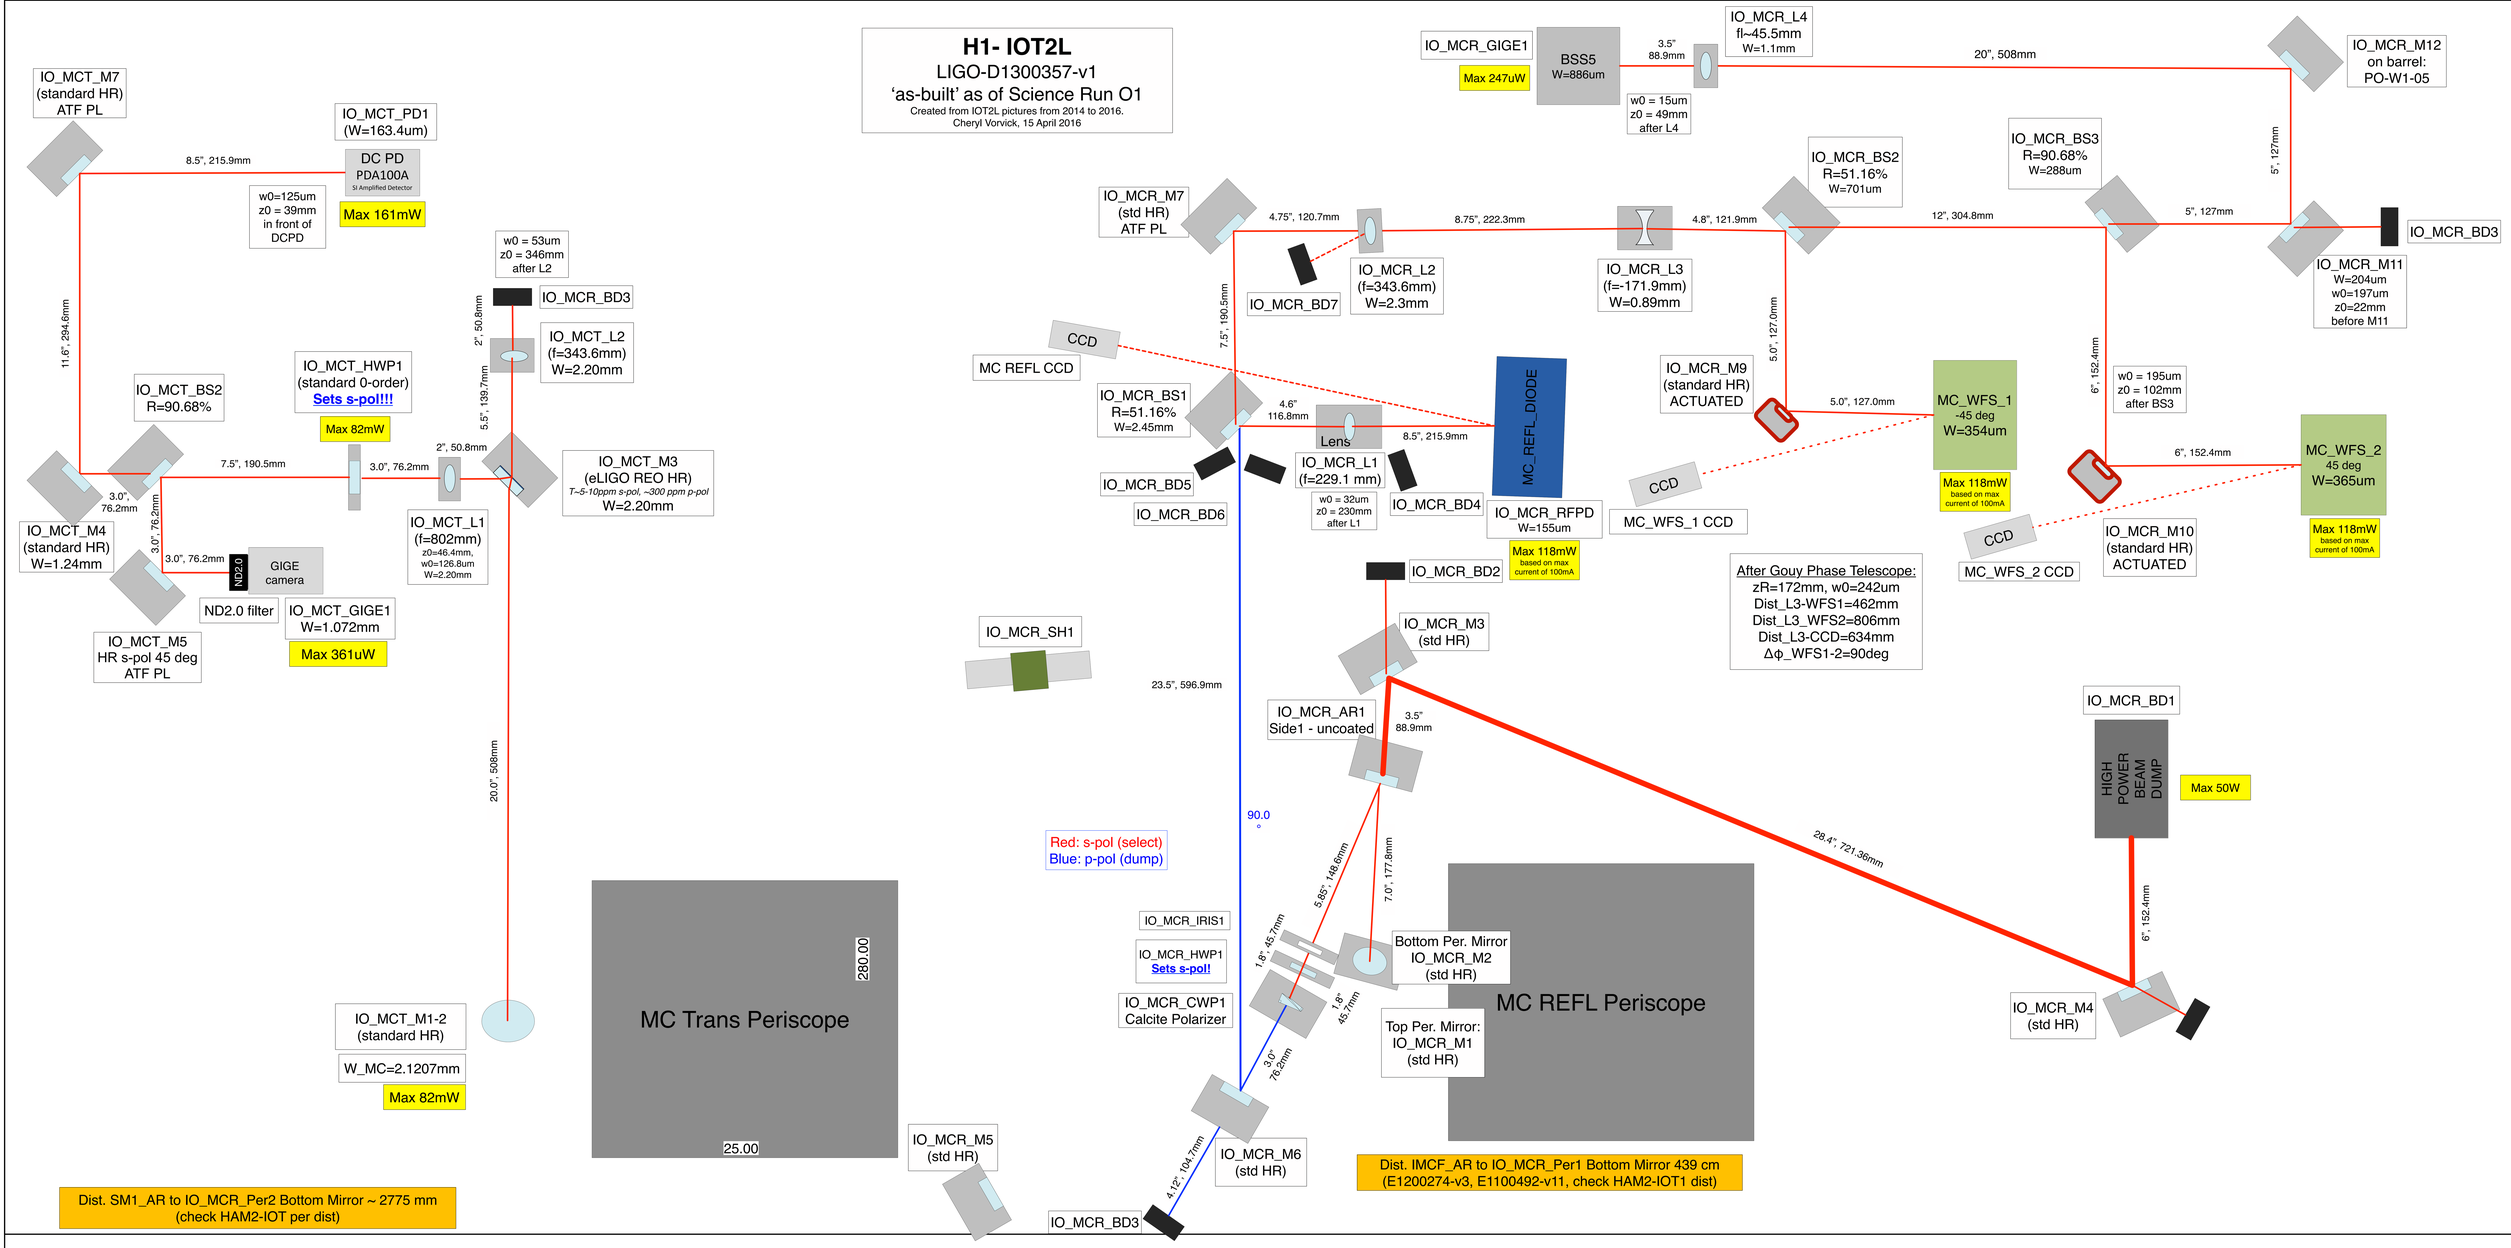
Created from IOT2L pictures from 2014 to 2016.
Cheryl Vorvick, 15 April 2016